


DOOR / DOOR HARDWARE

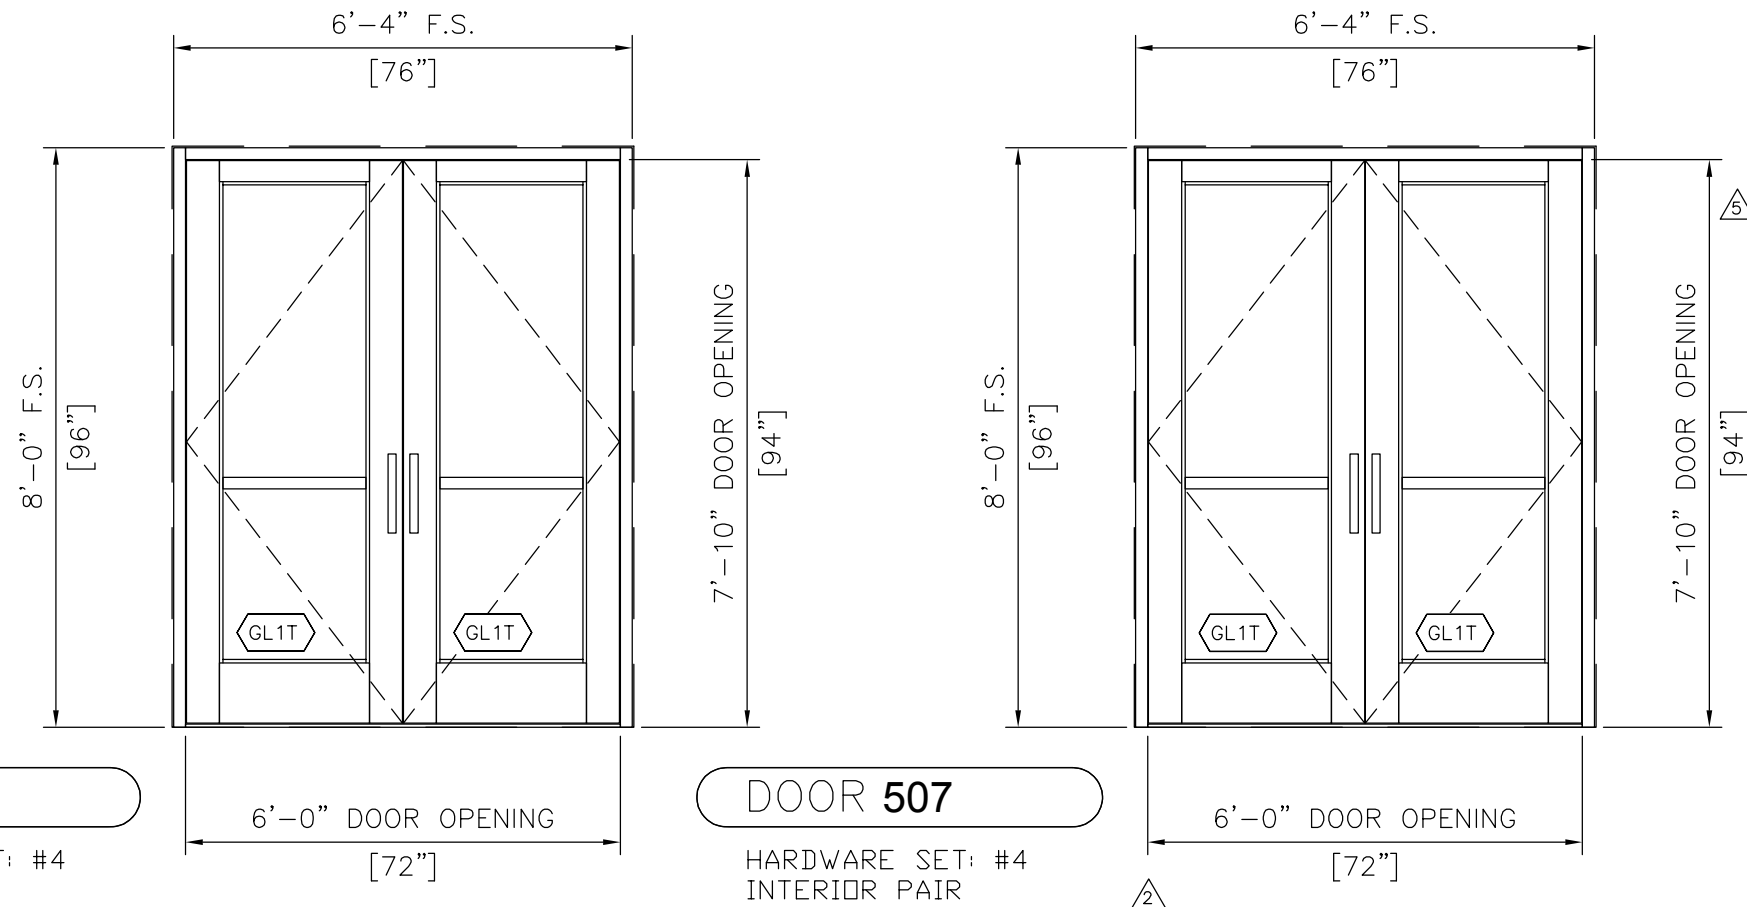

MEDIUM (350) STYLE DOOR	
VERTICAL STILES	3-1/2"
TOP RAIL	5"
BOTTOM RAIL	10"
CROSS RAIL	NONE
GLASS STOPS	BEVEL
GLAZING	1/4"
VERTICAL FRAMING	451-501 S/A
HEADER	451-502 S/A

HARDWARE SET 4.0				
2	PIVOT SET	195 X 180	626	RF
3	INTERMEDIATE PIVOT SET	M19	626	RF
1	ELECTRIC INT-PIVOT SET	EM19 QC	626	RF
1	EXIT DEVICE (EXIT ONLY)	7720	630	YA
1	ELECTRIC EXIT DEVICE	7200 XBXPX 12INL K645XCT6SL	630	YA
1	PERMANENT CORE	K600	626	YA
2	DOOR PULL	RM3311 X 12" L.D.H. X MP	US32D	RD
2	DOOR CLOSER	CLP7500	689	ND
2	DROP PLATE	7788	689	ND
1	THRESHOLD	272A X L.A.R.		PE
1	KEY FOB READERT	BY SECURITY		
1	POWER SUPPLY	782		YA
1	ELECTRO LYNX HARNESS	QC-CXXXXP		MK
1	ELECTRO LYNX HARNESS	QC-C1500P		MK

REV.	DATE:	DESCRIPTION:
1	8-17-15	REVISED PER RF-0114 & 0116
2	11-2-15	REVISED PER REDLINE RETURNS 10-29-15
3	11-16-15	REVISED PER COORDINATION WITH
4	1-25-16	REVISED PER ASI-018
5	2-15-16	REVISED PER REDLINE RETURN 08000.1.4.C.3
6	2-19-16	REVISED PER ASI-012 [LEVEL-5 HANDRAIL]
7	3-15-16	REVISED PER ENGINEERING CALCULATIONS

DATE:	PROJECT NAME:
DRAWN BY: MN	ADDRESS:
CHECKED BY:	CUSTOMER:
DRAWING TYPE:	ARCHITECT:
SHEET	
103	