


INFILL KEY

- VISION
- SPANDREL
- VENT SCREEN

SC2 SOUTH ELEVATION CURTAIN WALL
422

[1] REQ'D THUS TOTAL
8TH FLOOR TO PARAPET SOUTH
KAWNEER 1600 SS [2 1/2" X 6"]
EXTERIOR GLAZED

ALL CONNECTIONS TO BE
DEADLOAD UNLESS INDICATED
OTHERWISE W.L. = WINDLOAD

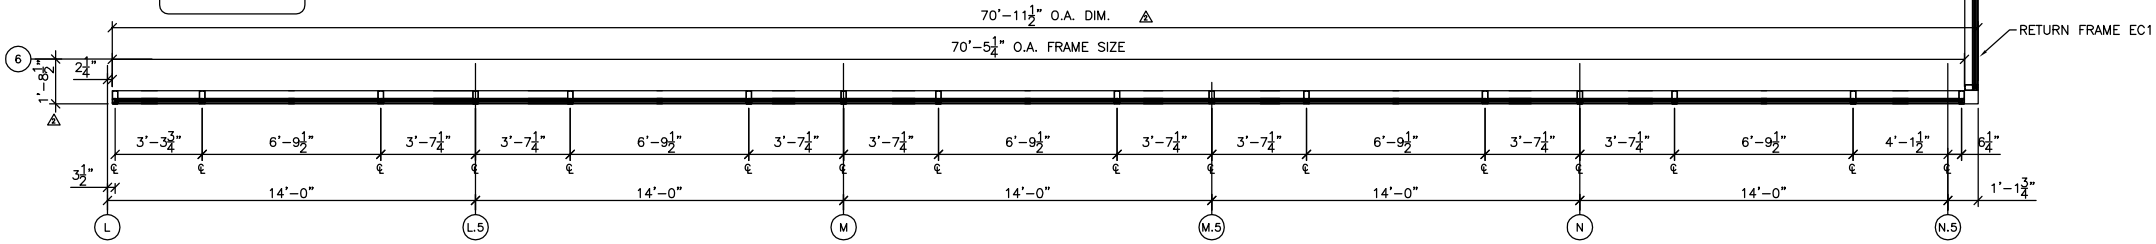

REV.	DATE:	DESCRIPTION:
1	12-29-14	REVISED PER EMBED MODIFICATIONS
2	2-2-15	REVISED PER ARCH. RETURNS 1-13-15
3	3-9-15	REVISED PER ENGINEERING CALCULATIONS
4	7-16-15	REVISED PER CCD #2
5	7-27-15	REVISED PER ROOF SLAB FIX
6	8-10-15	REVISED PER CCD #2 REDLINE RETURN DWGS
7	8-20-15	REVISED PER NORTH ELEV. ENTRANCE CHANGE

PROJECT NAME:	ADDRESS:
CUSTOMER:	ARCHITECT:

DATE:	DRAWN BY:
	MIN
CHECKED BY:	
DRAWING TYPE:	

SHEET

422