



WS12 WALL SECTION
426

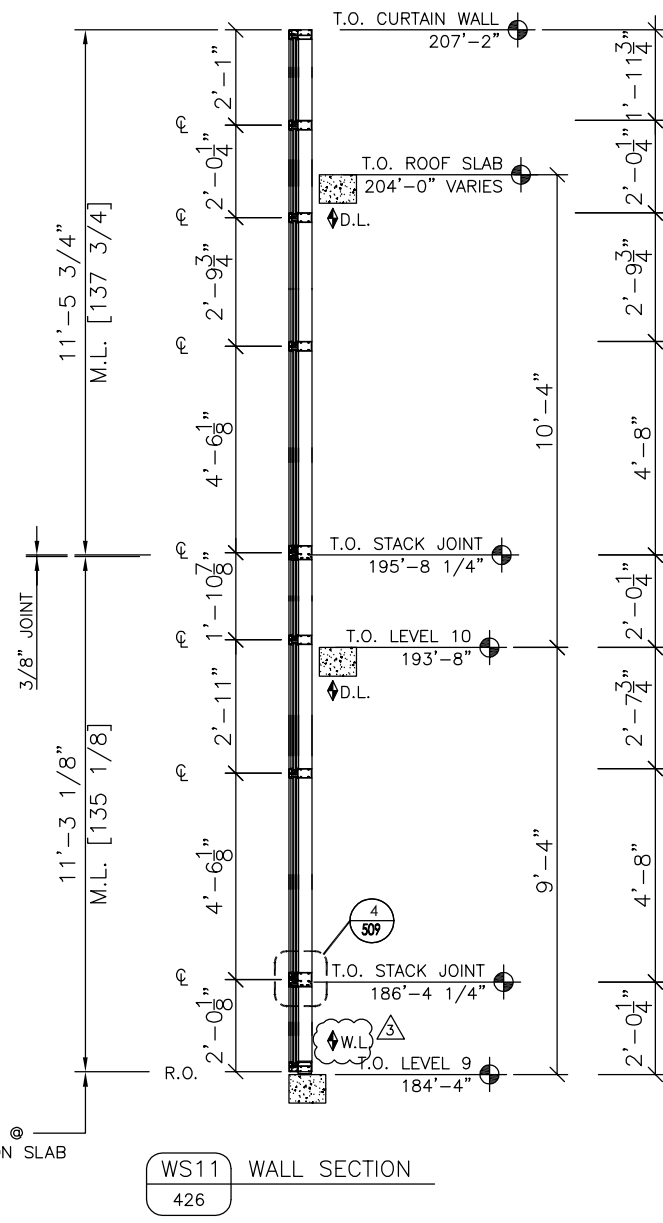

WS11 WALL SECTION
426

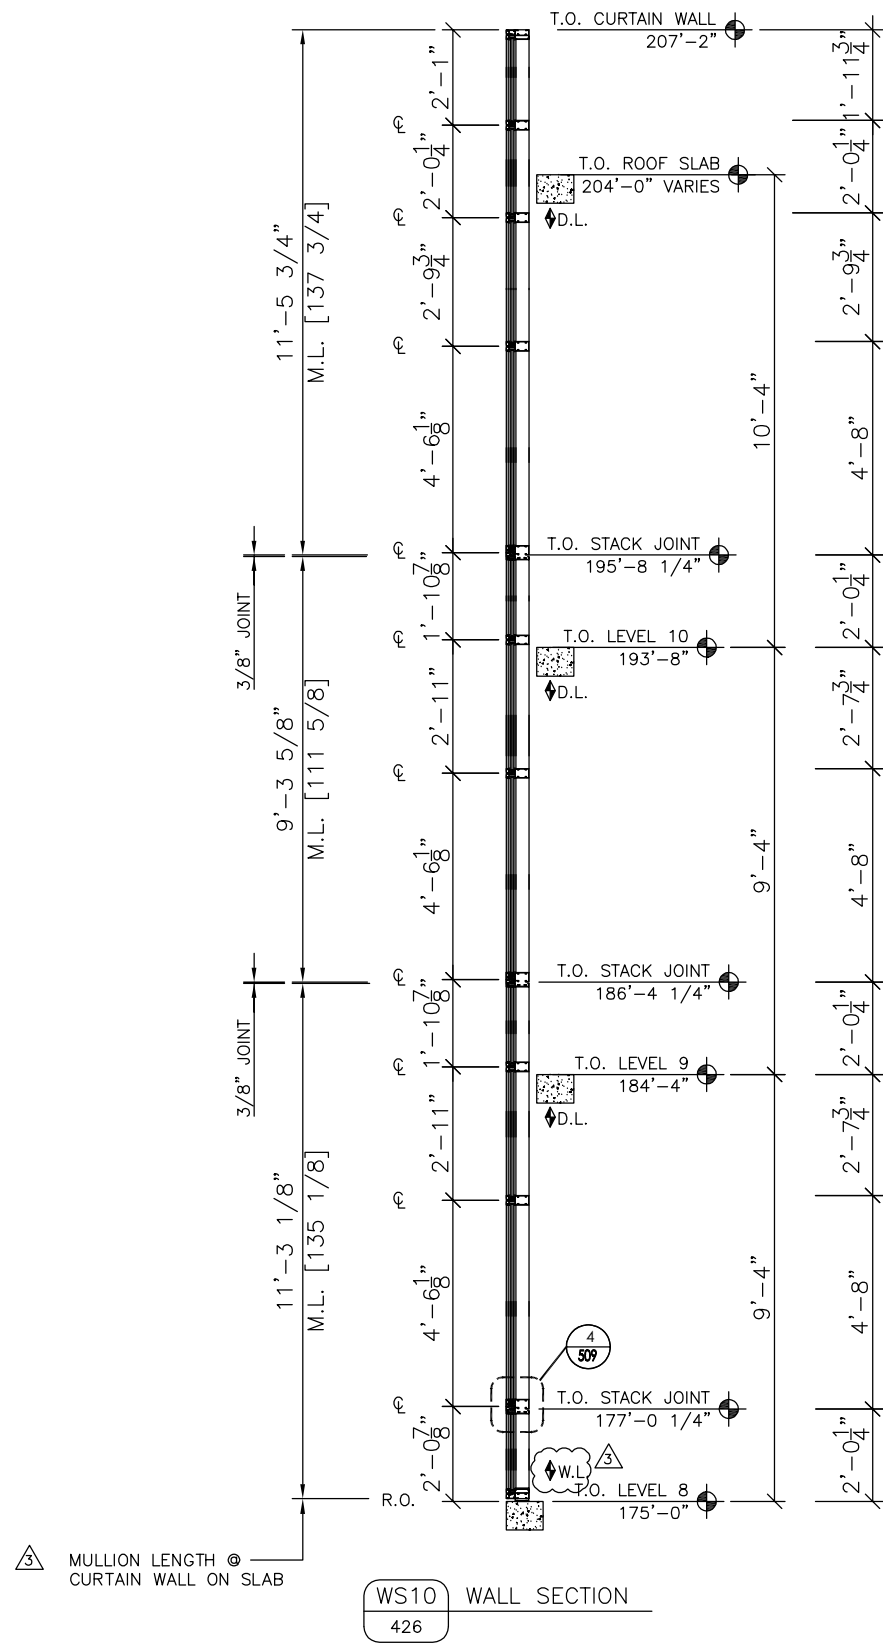

WS10 WALL SECTION
426

REV.	DATE:	DESCRIPTION:
1	12-29-14	REVISED PER EMBED MODIFICATIONS
2	2-2-15	REVISED PER ARCH. RETURNS 1-13-15
3	3-9-15	REVISED PER ENGINEERING CALCULATIONS
4	7-16-15	REVISED PER CCD #2
5	7-27-15	REVISED PER ROOF SLAB FIX
6	8-10-15	REVISED PER CCD #2 REDLINE RETURN DWGS
7	8-20-15	REVISED PER NORTH ELEV. ENTRANCE CHANGE

PROJECT NAME:	
ADDRESS:	
CUSTOMER:	
ARCHITECT:	

DATE:	
DRAWN BY:	MN
CHECKED BY:	
DRAWING TYPE:	