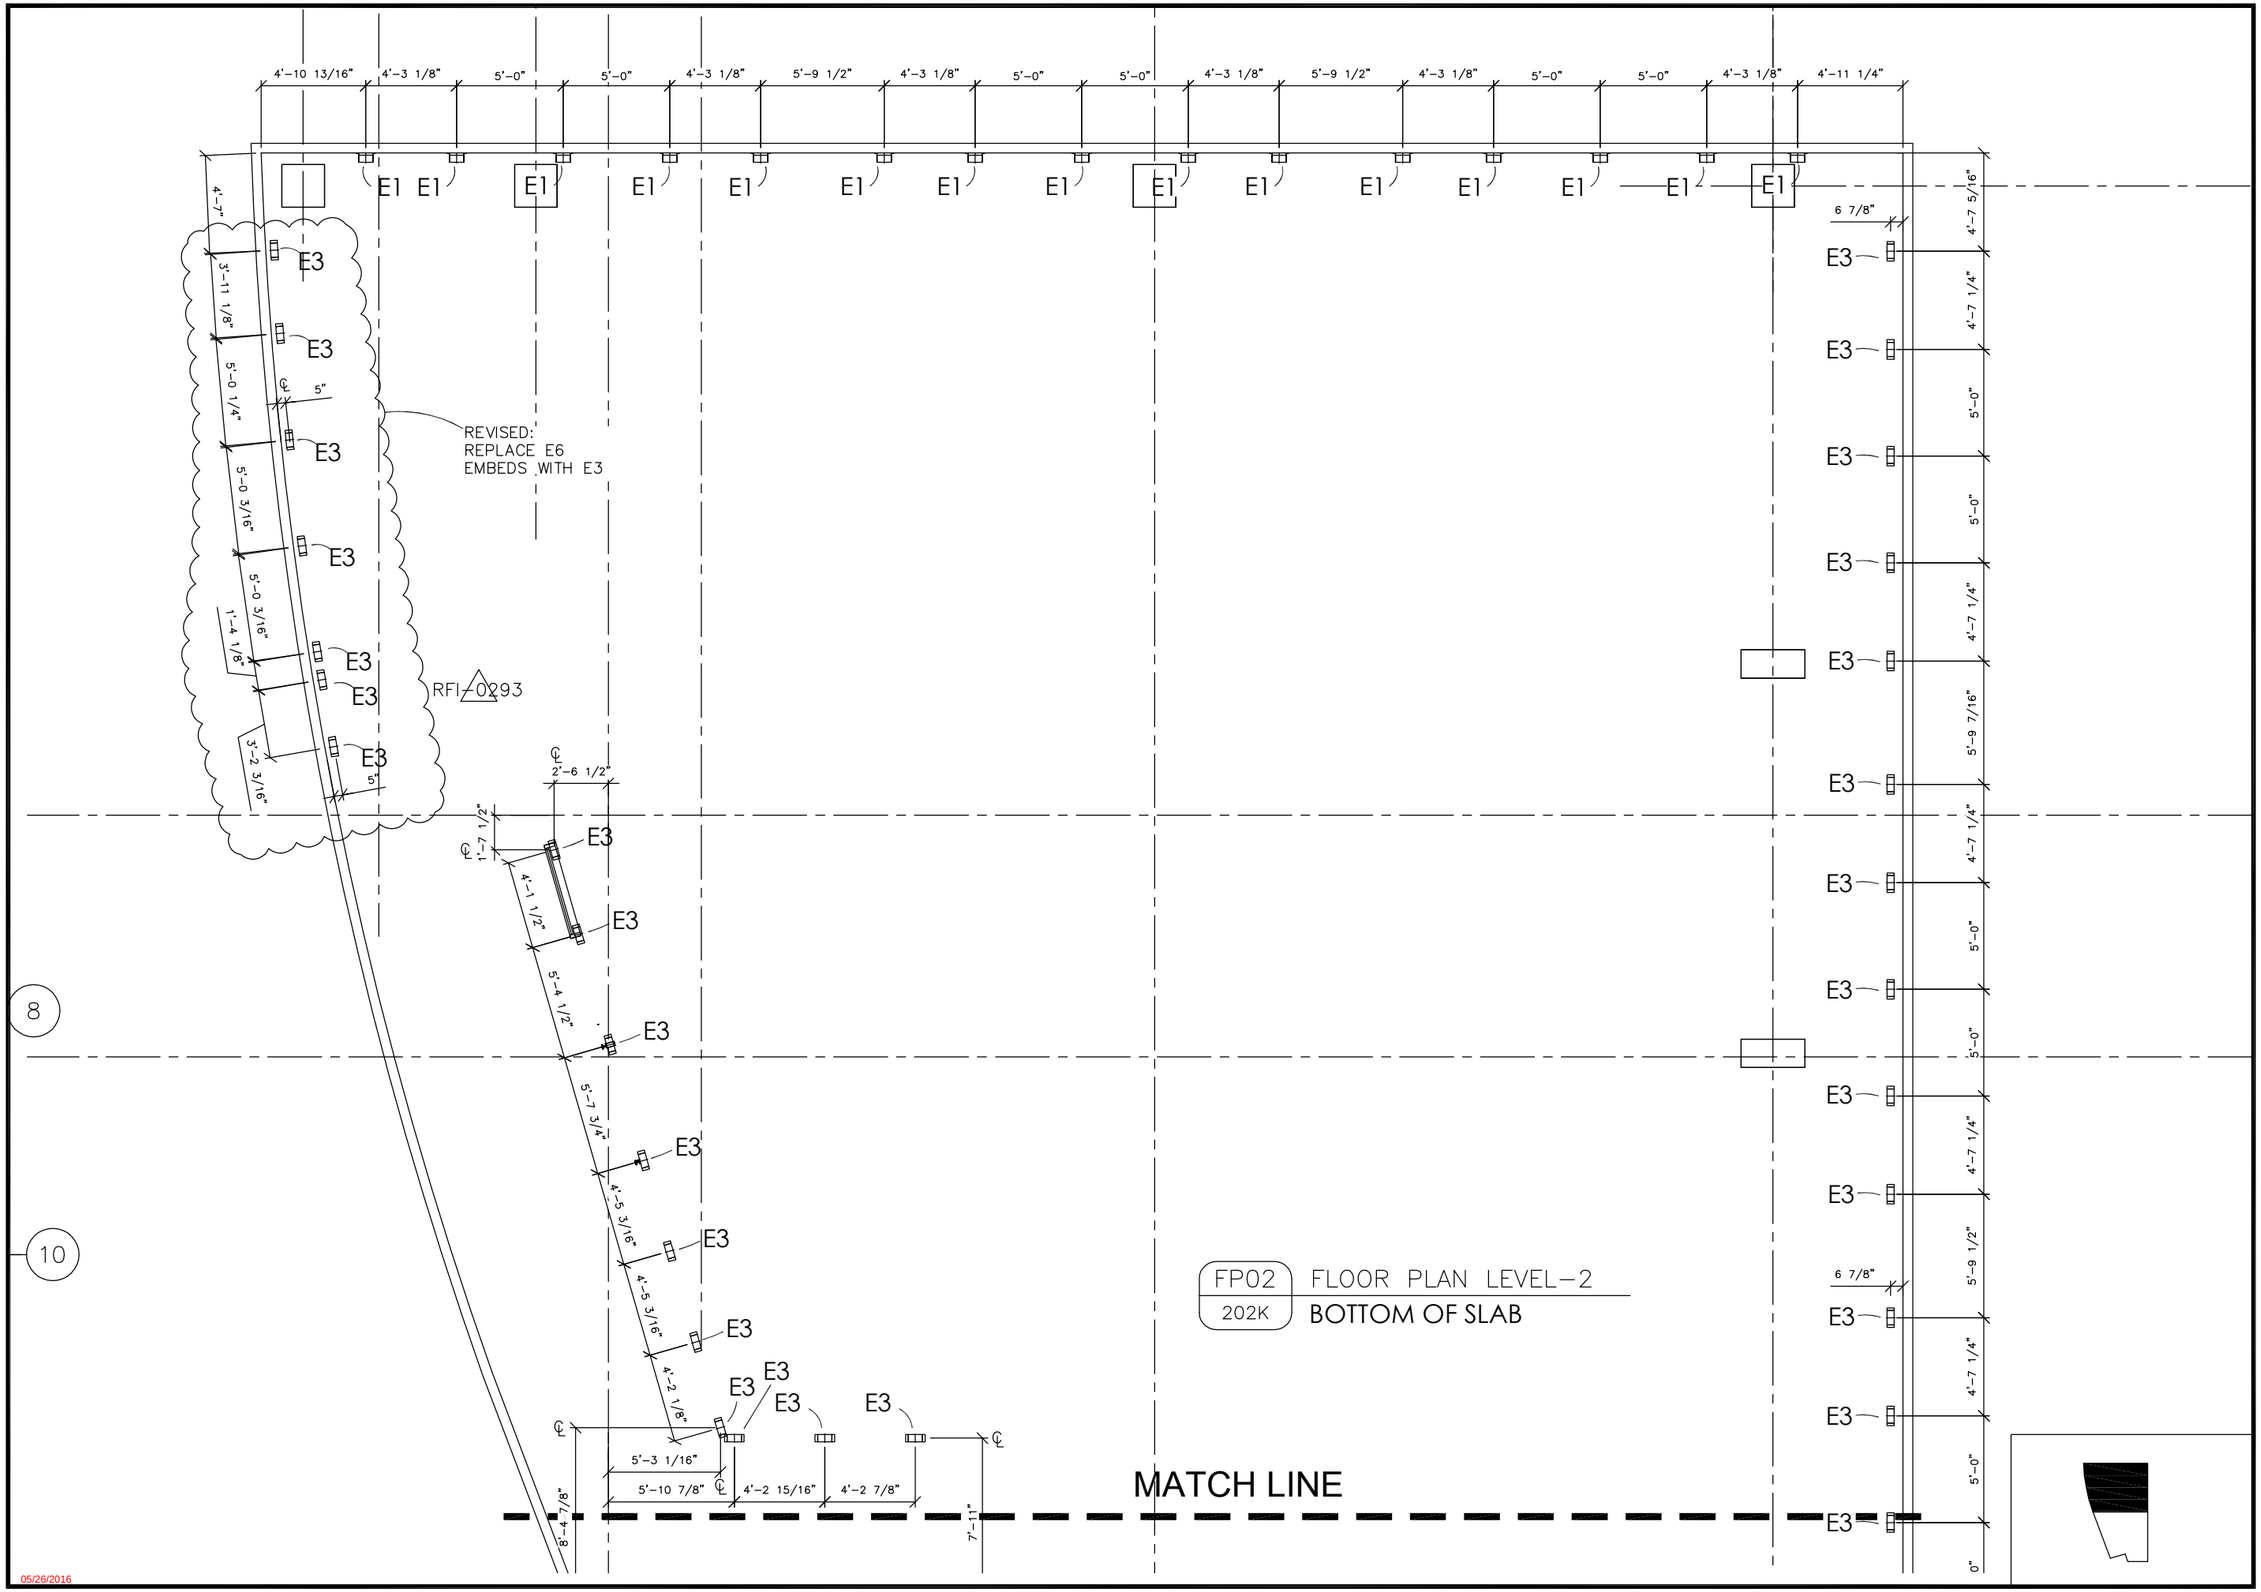

FP02 FLOOR PLAN LEVEL-2

202K BOTTOM OF SLAB

05/26/2016

REV.	DATE:	DESCRIPTION:
1	7-7-2015	REVISED PER ASI-12
2	10-9-2015	REVISED PER RETURNED REDLINES 10-8-15
3	11-16-2015	REVISED PER COORDINATION WITH
4	12-23-2015	REVISED PER REDLINE RETURN 12-16-15
5	1-8-2016	REVISED PER ENGINEERING CALCULATIONS
6	1-8-2016	REVISED PER ASI-018

PROJECT NAME:

ADDRESS:

CUSTOMER:

ARCHITECT:

DATE:

DRAWN BY: MN

CHECKED BY: -

DRAWING TYPE:

SHEET E202K